

PREPARED IN CONJUNCTION WITH:							
	01						
	Drg No	Revisions					
L	AR-80-A-001	87					
L	AR-80-A-002	10					
	ST-80-A-001	C0					
	XF-80-TF-ZZ	21					
	XE-80-TF-ZZ	18					
	XP-80-TF-ZZ	11					

AN

## **GENERAL NOTE:**

- Generally all supply and return air ductwork are internally or externally insulated 50mm thermal as shown on plans and/or sections.

Generally all acoustic insulation linings are 50mm with perforated foil.

Ref to plans and/or section for insulation tags.

Allow for penetration flashing angles to all wall openings for one or both sides of opening as necessary subject to where visible. ie: visible on one side one flashing, two sides two flashings.

Allow for appropriate size A/P at all FD access for inspection if shown or not on drawing.

Provide seismic restraint to all MECH services as necessary to project code requirement.


Allow turning vane's to all short rad and/or 90° bends if shown or not.

Allow all support brackets for "FAN, COND, etc" where shown or not.

Allow pipe support and expansion as required. Refer to water schematic for location.

All Mechanical Ductwork ,Pipework exposed to view shall be painted Colour selectoin Accordint to Australian Standard and Approved by Principal in Risers, palntrooms excludes above ceiling , below floor concealed areas and carpark area.

All Temprature sensor has to be installed 1500mm FFL

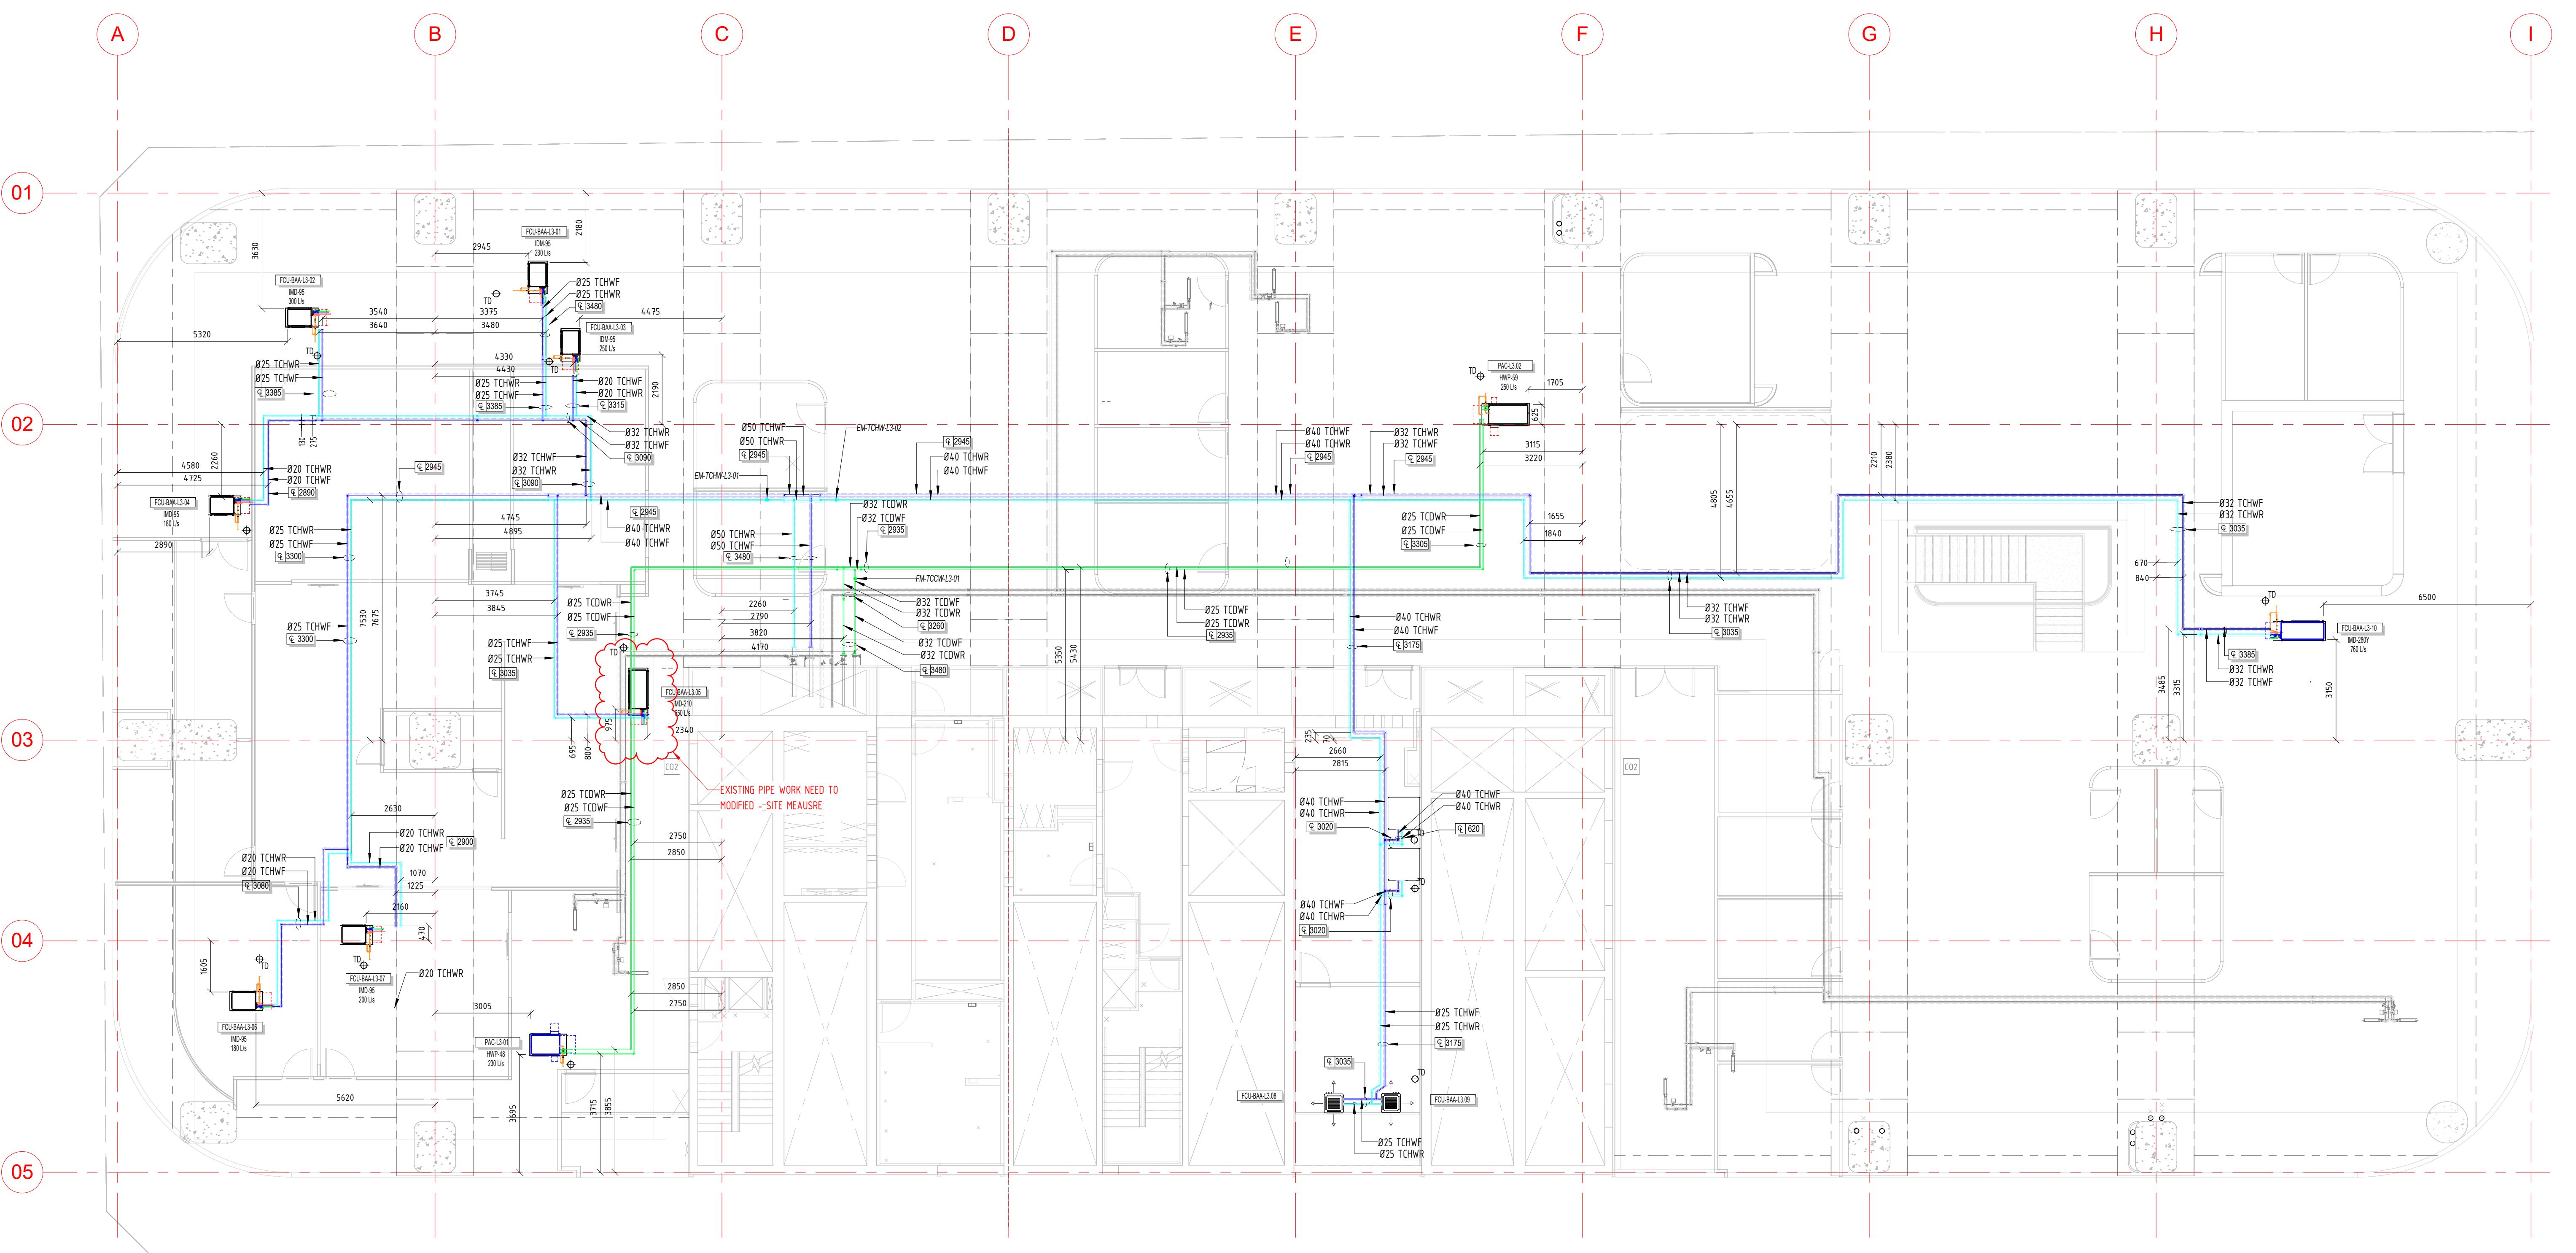

	AS BUILT	OES
03	ISSUED FOR INTERNAL QA-CONSTRUCTION	OES
	UNIT REFRECE DIMENSIONS ADDED	OES
02	ISSUED FOR INTERNAL QA-CONSTRUCTION	OES
01	ISSUED FOR INTERNAL QA-CONSTRUCTION	OES
	ISSUED FOR APPROVAL	OES
	REVISION	DATE

E NAME: \_\_\_\_\_  
ECT

---

CT

# MECHANICAL SERVICES LEVEL 03 LAYOUT WORK

DATE	DSGN CHECK	DATE
DATE	DRG CHECK	DATE
ACT NUMBER	SCALE@B1	
1:100		
ING NUMBER	ISSUE	
<b>AB</b>		

**NOTE :  
ALL DIMENSIONS ARE TAKEN FROM ST RL 76400**